

REVISION

DATE

DESCRIPTION

A

11-11-15

SPAN BETWEEN GRIDLINES A AND B REDUCED TO 12,000mm.

B

05-01-2016

TENDER ISSUE

C

18-01-16


ADDITIONAL LAYER OF FIRE PROTECTION BOARD ADDED TO UNDERSIDE OF 'LID' IN ACCORDANCE WITH ACOUSTIC CONSULTANTS REPORT

D

06-07-16

REVISION TO CONSTRUCTION OF 'LID' TO OFFICES. SPECIFICATION OF SKIRTINGS AND WINDOW BOARDS REVISED

RECORD DRAWING

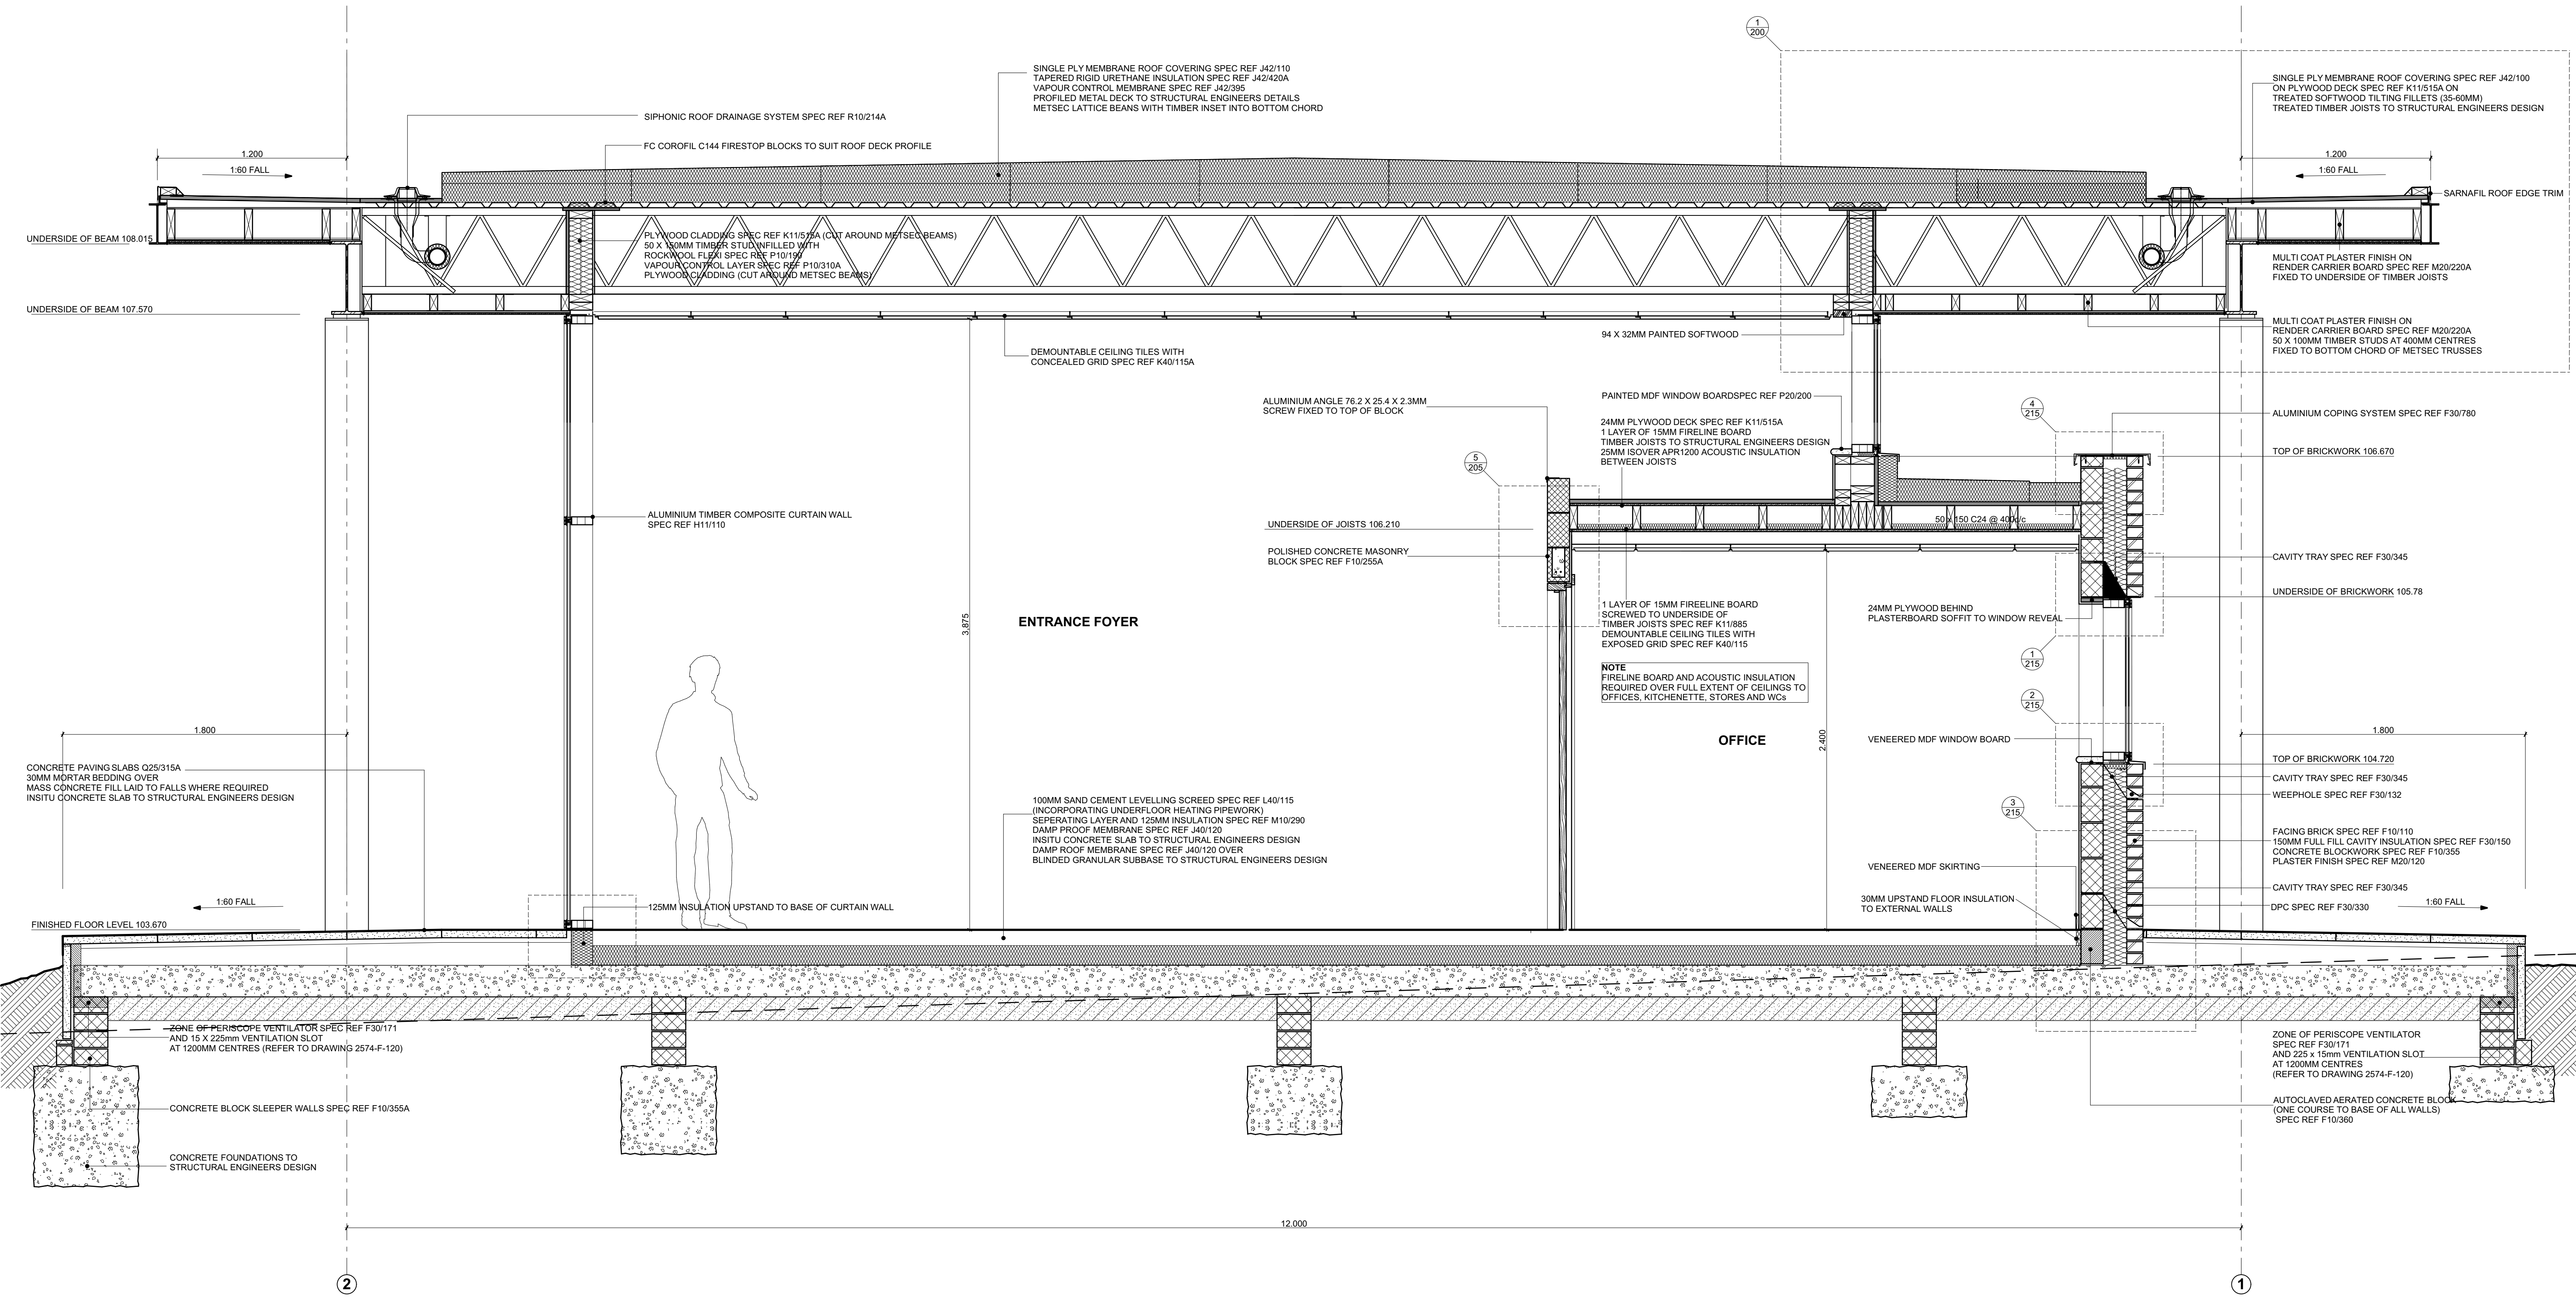

SECTION A-A

NOTE: DWG Files are provided FOR INFORMATION only. DWG Files are generated from ArchiCAD. Non-editable Hardcopies and PDF Files take precedence and in the event of any discrepancies please advise the Architect immediately.

DRAWING TITLE:

DETAILED SECTION A-A

JOB DESCRIPTION:

WREKIN COLLEGE BUSINESS SCHOOL

DRAWING SCALE:

1:20 @ A1

DATE:

14-08-2015

DRAWING REF:

2574-F-105D

BAART HARRIES NEWALL

ARCHITECTS

1 WILDERHOPE HOUSE

POUNTERY GARDENS

BELLE Vue

SHREWSBURY SY3 7JU

Fon: 01743 364944

Tel: 01743 361261