


During the GNSS RTK survey, maintaining a consistent connection was difficult, resulting in intermittent signal loss. Satellite geometry remained acceptable, with PDOP (2.02), HDOP (1.10), and VDOP (1.70), achieving accuracies of 0.034 m in elevation and 0.022 m in 2D. The unstable connection may have introduced minor positional inconsistencies within the data. All elevations are measured AOD

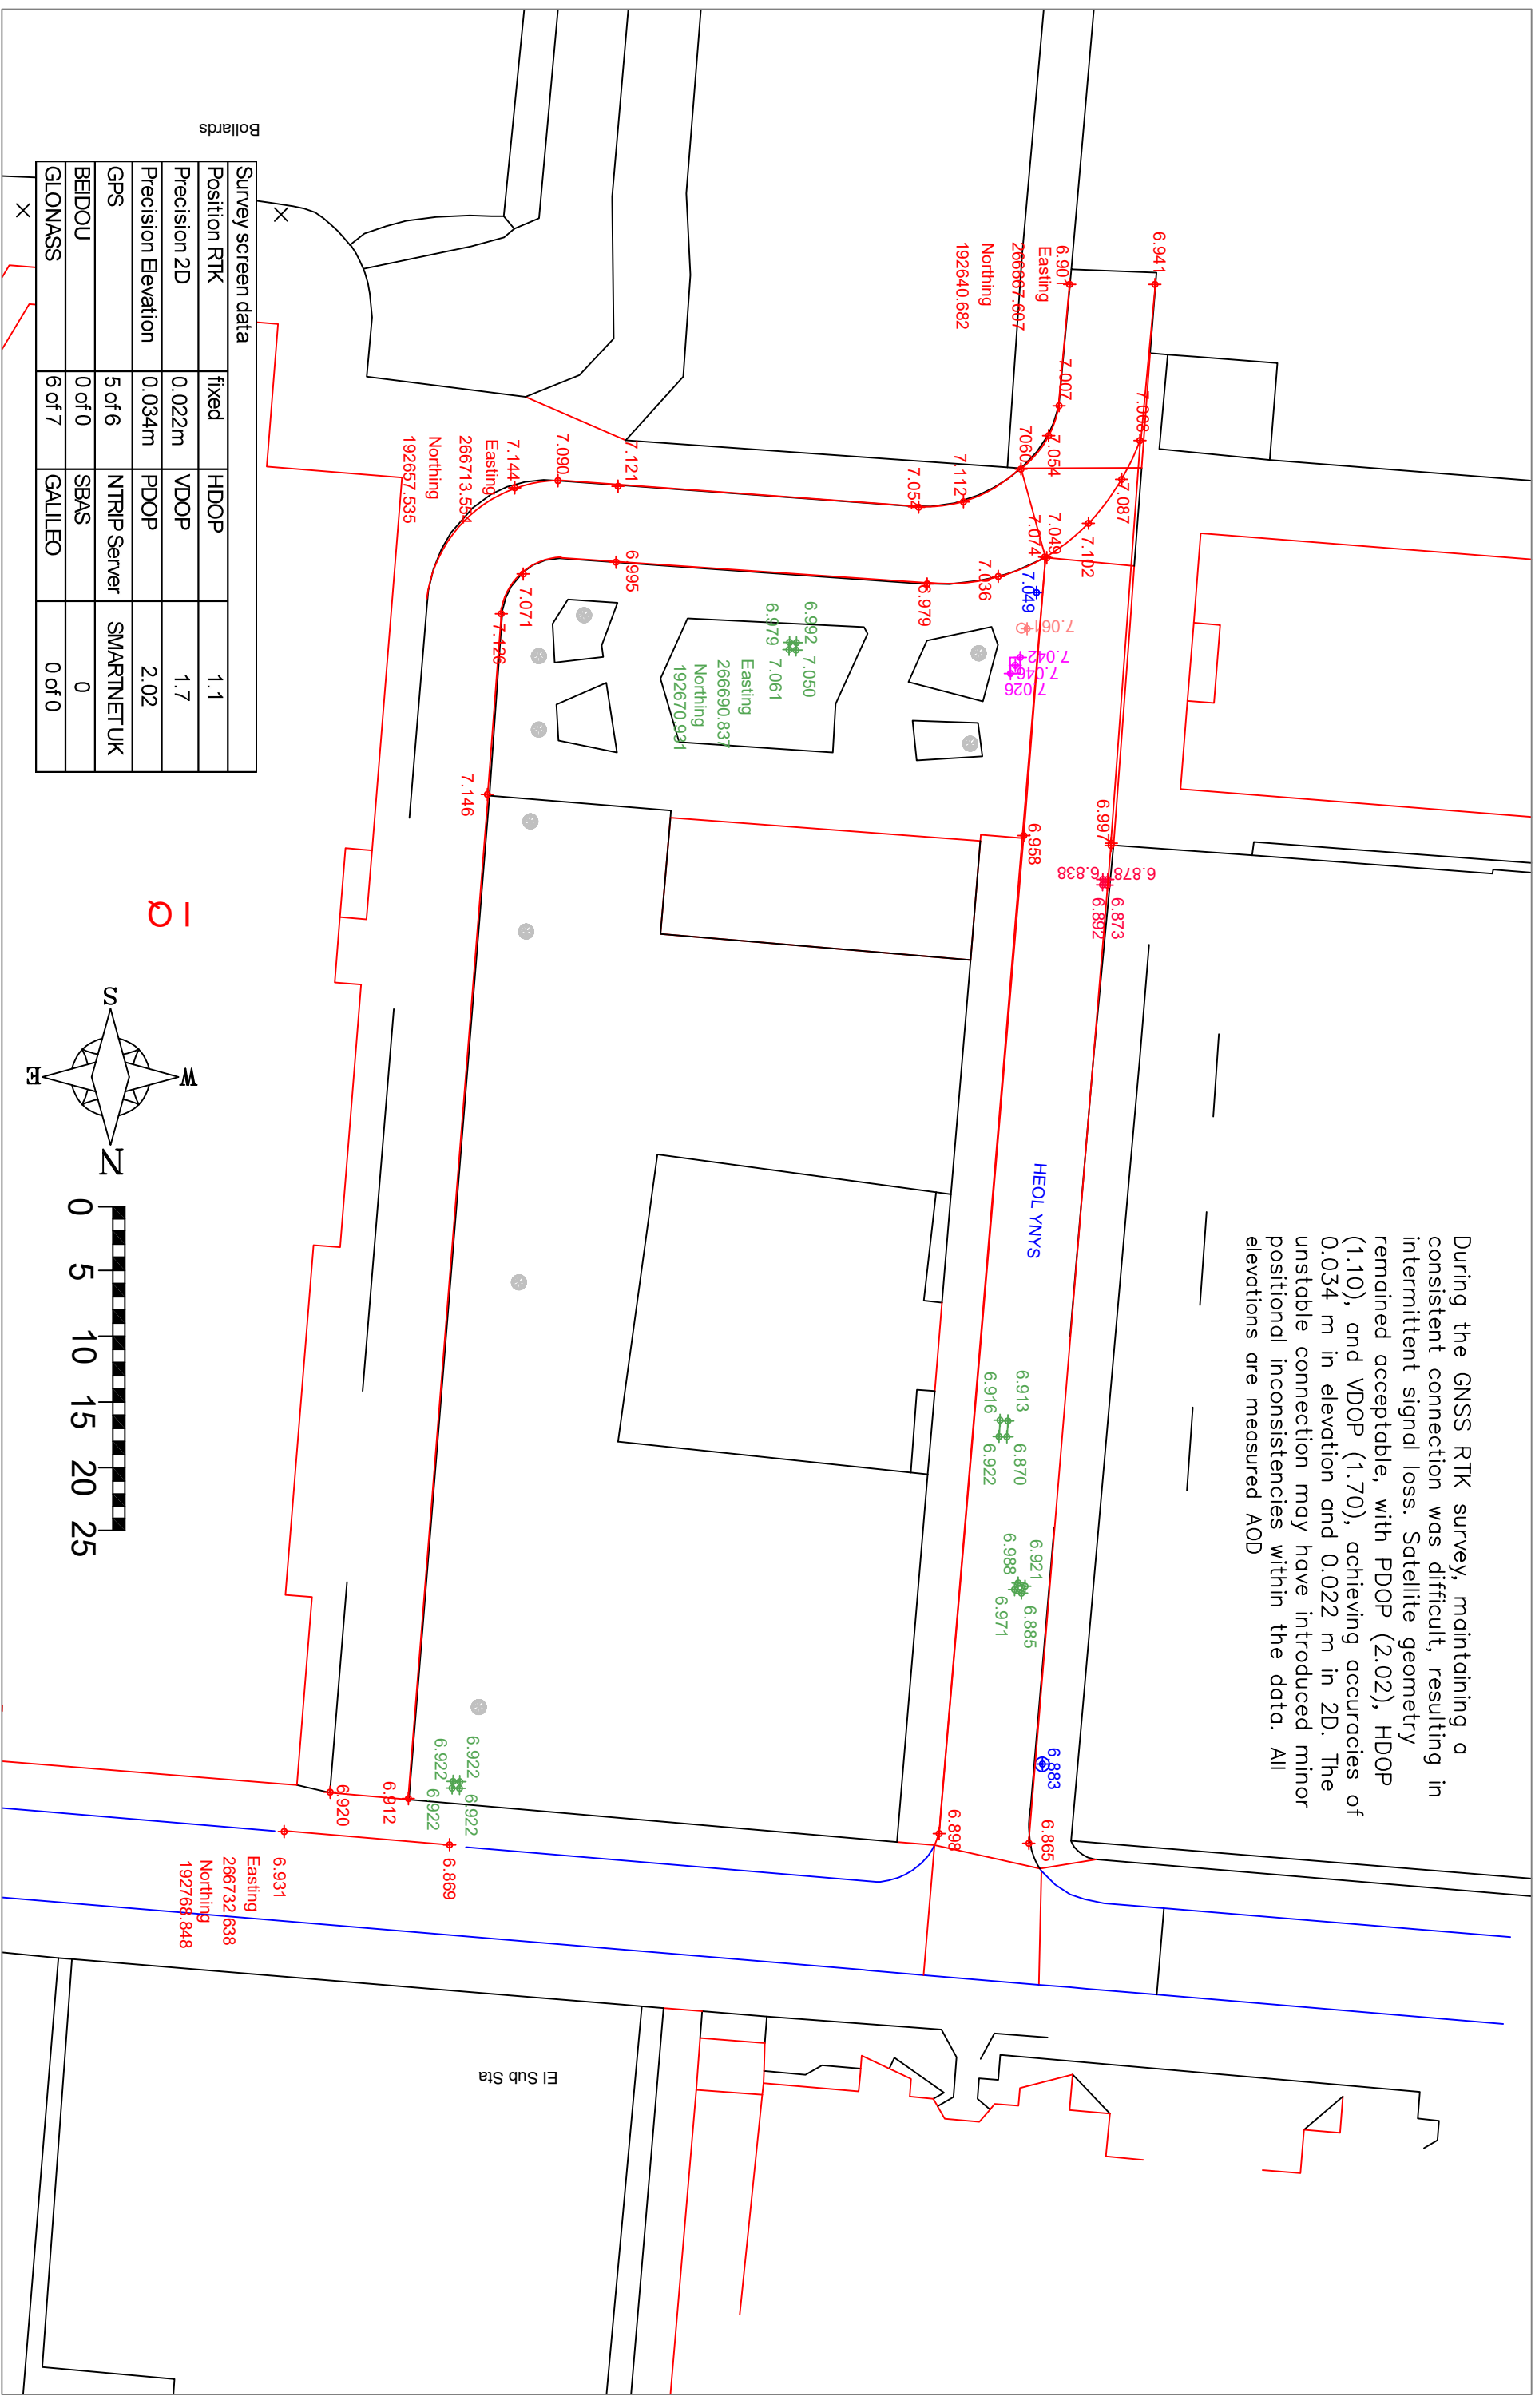

Survey screen data			
Position RTK	fixed	HDOP	1.1
Precision 2D	0.022m	VDOP	1.7
Precision Elevation	0.034m	PDOP	2.02
GPS	5 of 6	NTRIP Server	SMARTNET UK
BEIDOU	0 of 0	SBAS	0
GLONASS	6 of 7	GALLILEO	0 of 0

Property Title															Detail																															
As-Built Survey															ACBA4020																															
<table><tr><th>Property</th><th>Originator</th><th>Functional Breakdown</th><th>Spatial Breakdown</th><th>Form</th><th>Discipline</th><th>Number</th><th>Description</th><th>Status</th><th>Revision</th></tr><tr><td>UPRN</td><td>UWMTSD</td><td>.</td><td>.</td><td>.</td><td>.</td><td>0001</td><td>.</td><td>.</td><td>.</td></tr></table>															Property	Originator	Functional Breakdown	Spatial Breakdown	Form	Discipline	Number	Description	Status	Revision	UPRN	UWMTSD	.	.	.	.	0001	.	.	.	scale	1:200 @A3	drawn	P.F	checked	date	27/04/2026	H.W	Prifysgol Gymru Y Ddrindod Dewi Sant University of Wales Trinity Saint David	(S0) UNCONTROLLED ISSUE NOT TO BE USED AS A REFERENCE DOCUMENT CHECK STATUS BEFORE QUOTING	revisability	revision
Property	Originator	Functional Breakdown	Spatial Breakdown	Form	Discipline	Number	Description	Status	Revision																																					
UPRN	UWMTSD	.	.	.	.	0001	.	.	.																																					
Yr Awdurdod Sefydlaethol Cymru a Chymunedau															length	27/04/2026	H.W	SAI Campus Kegyn Road SA11 2ND	(S0) UNCONTROLLED ISSUE NOT TO BE USED AS A REFERENCE DOCUMENT CHECK STATUS BEFORE QUOTING	revisability	revision																									