



# RECORD DRAWING

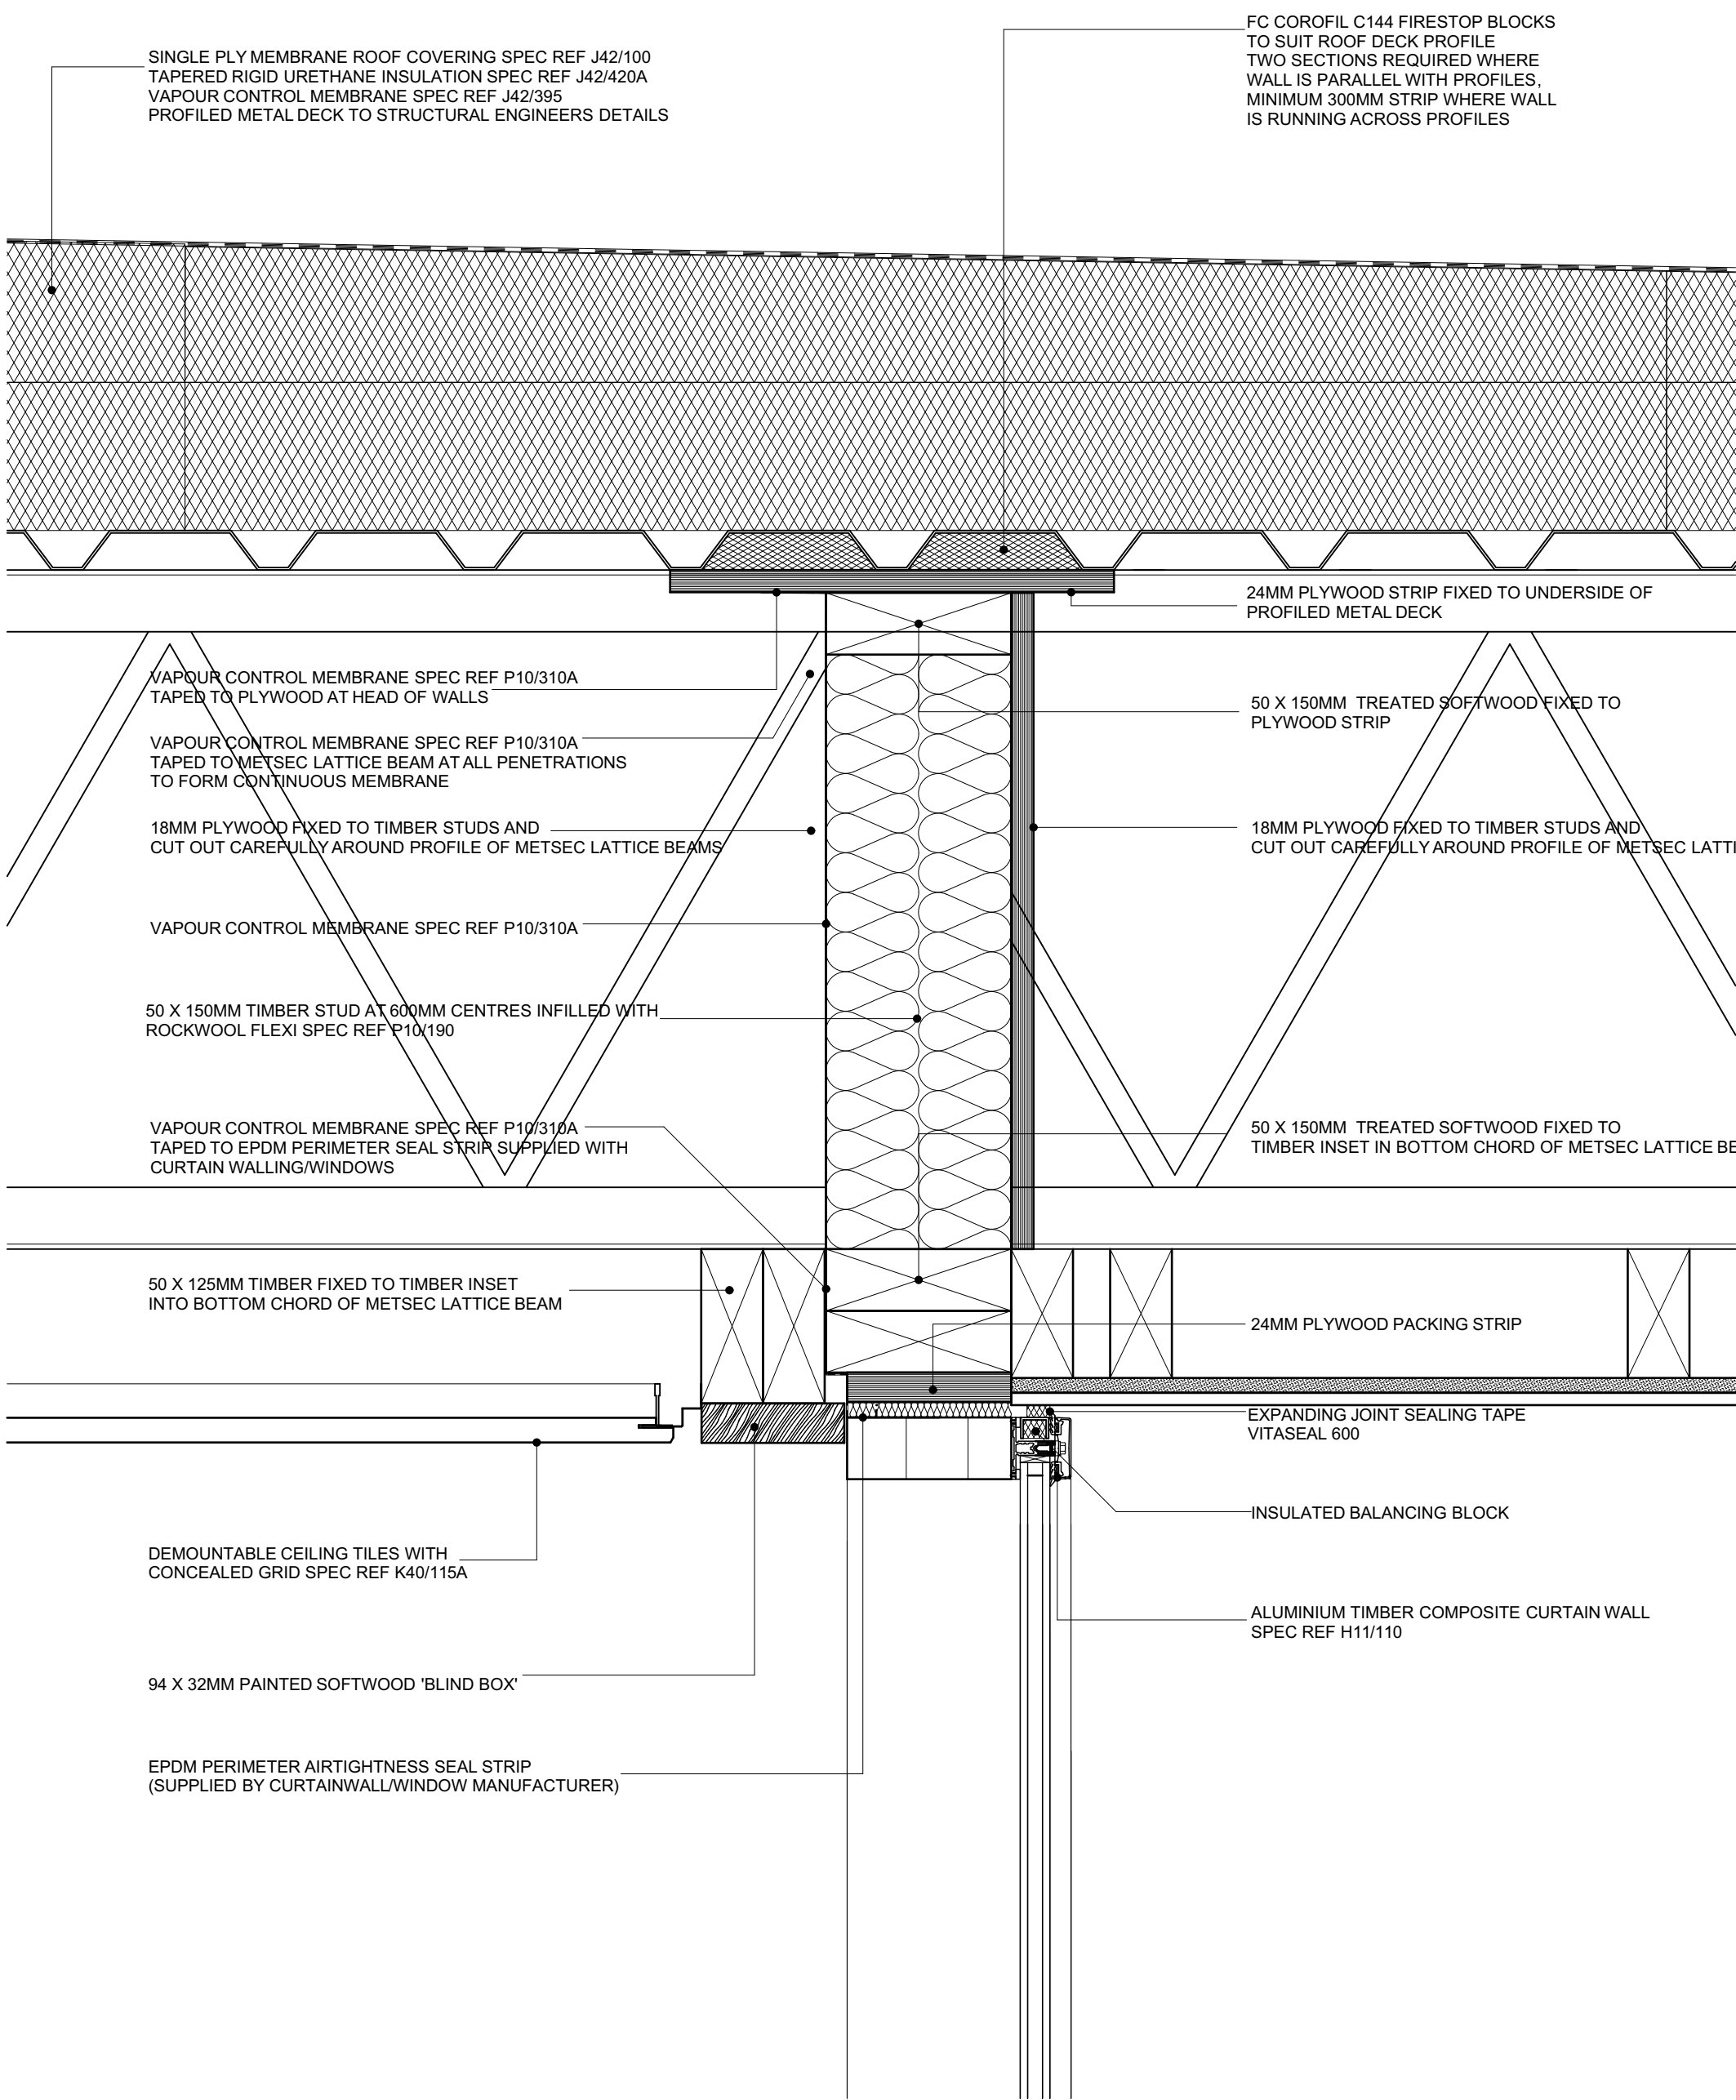

1. TYPICAL HEAD OF CURTAIN WALL/SOFFIT/ROOF INTERSECTION DETAIL

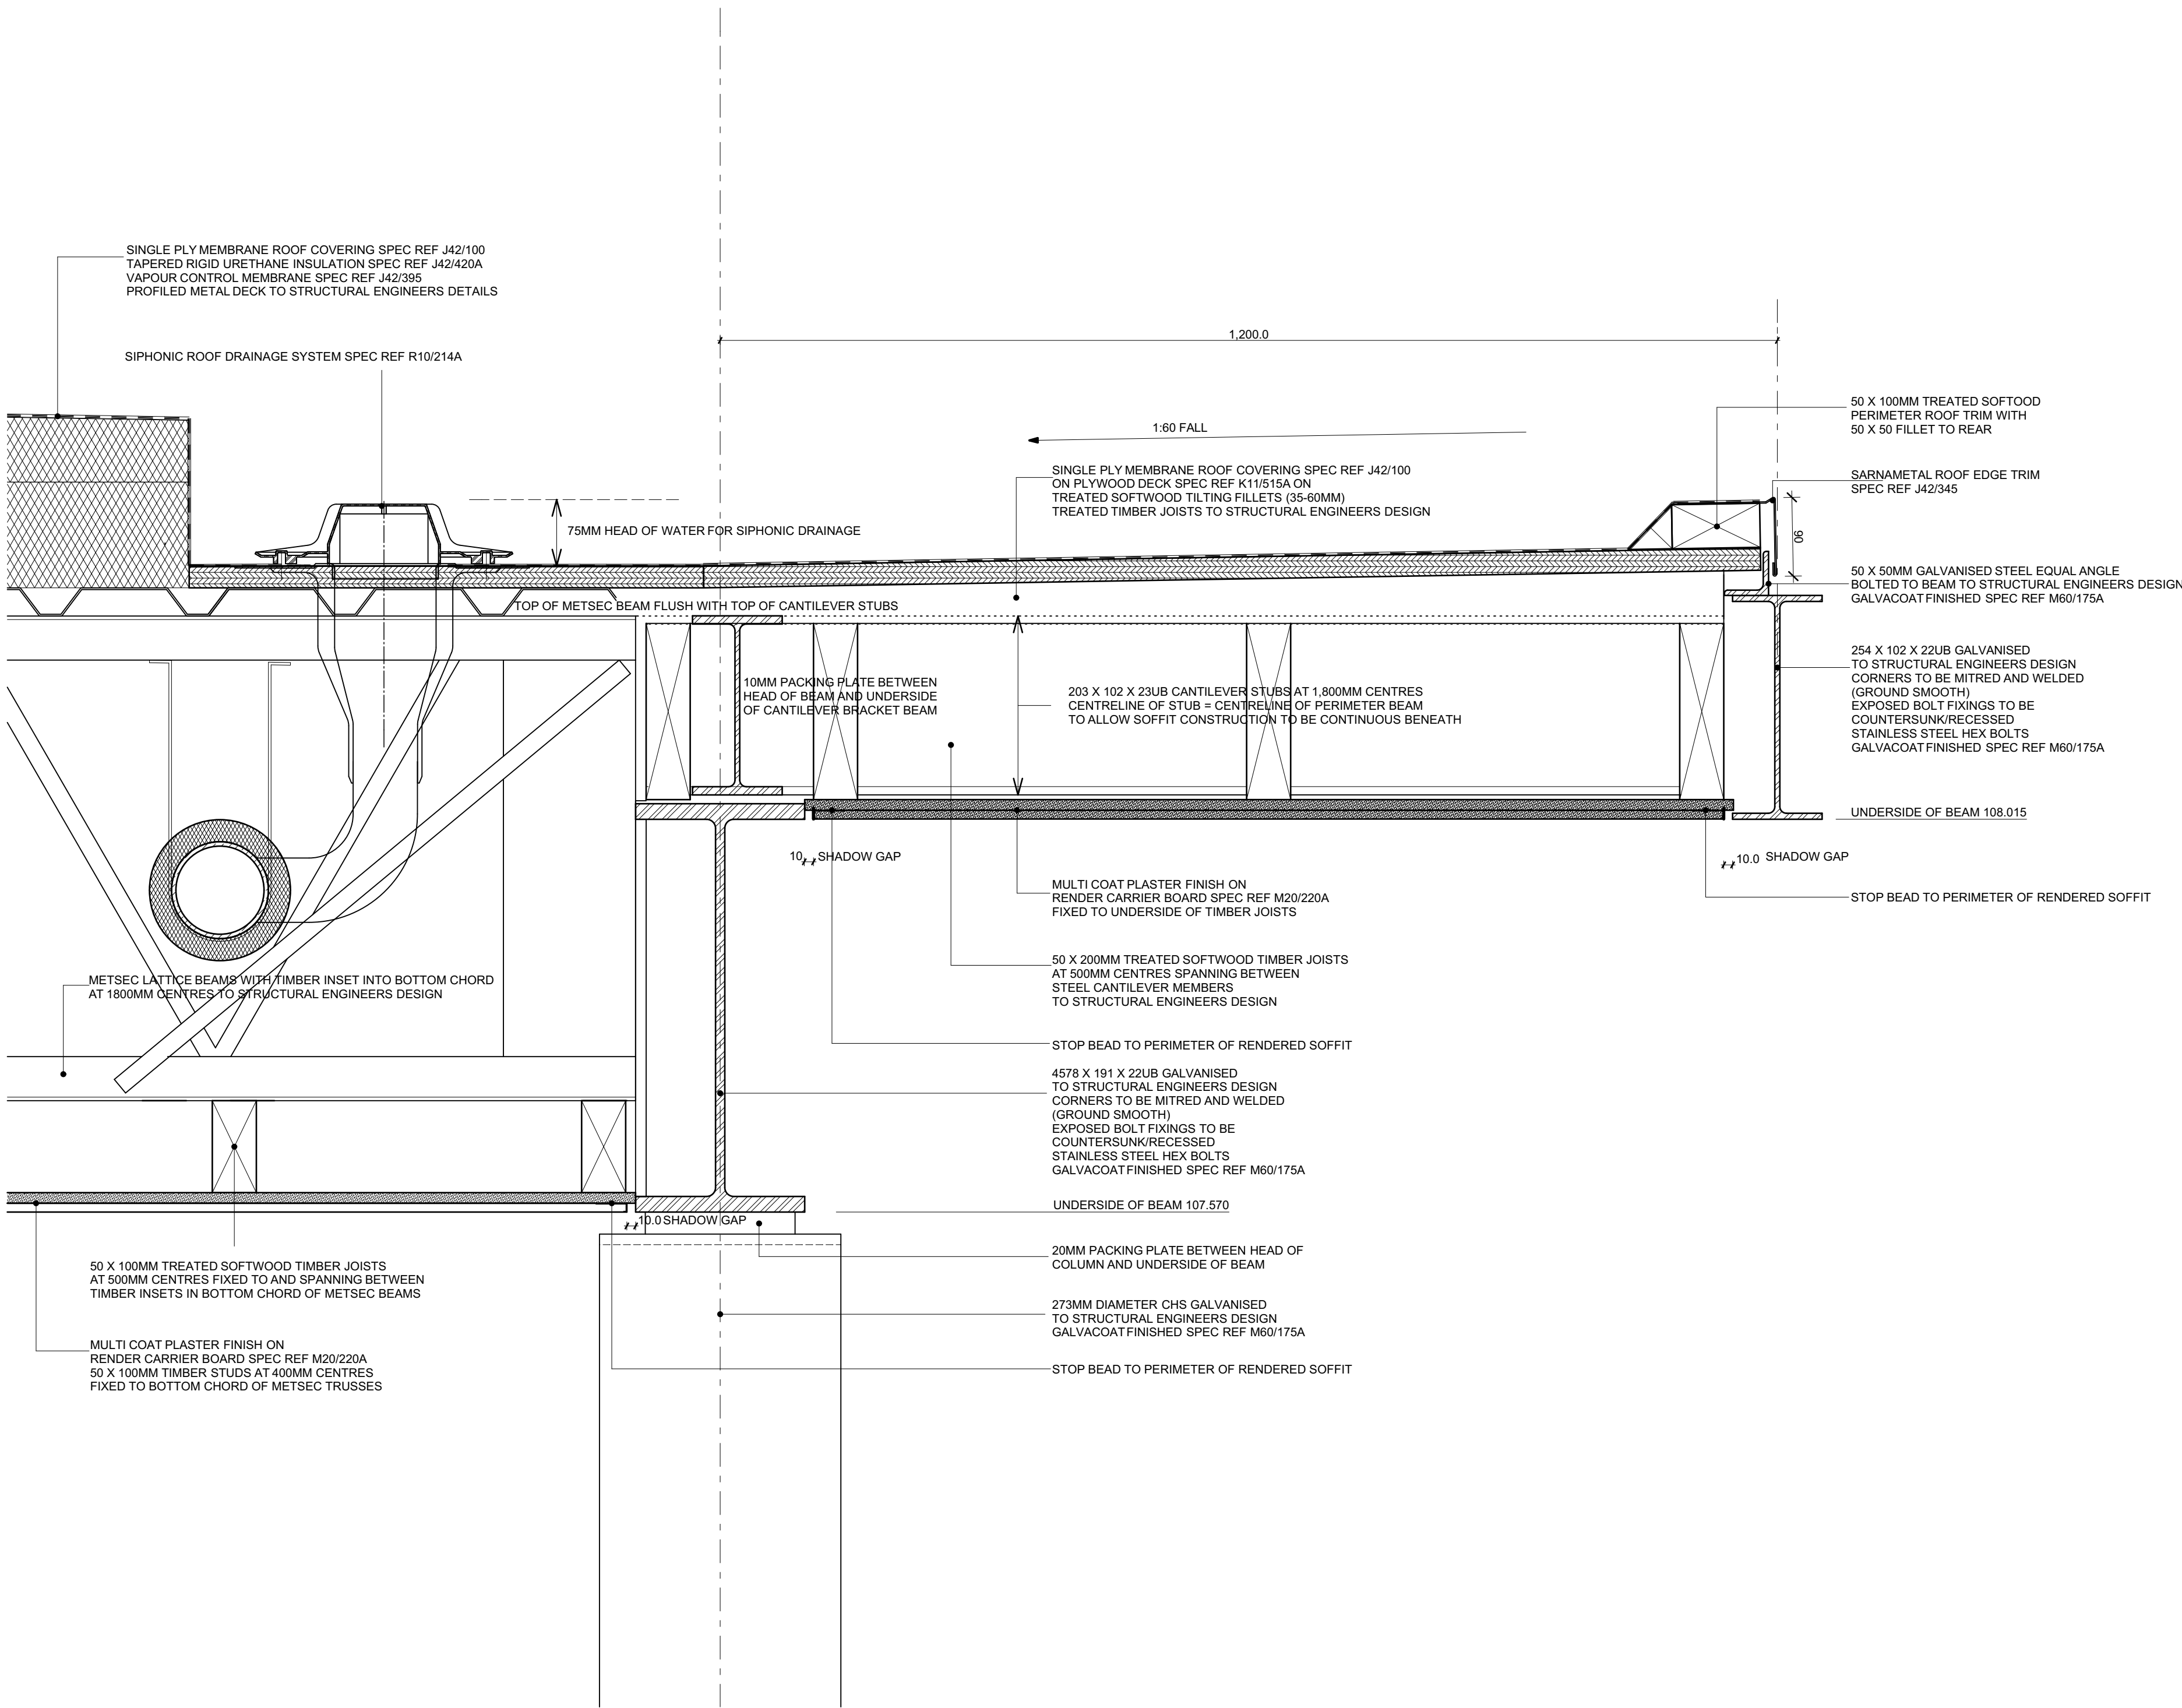

TYPICAL ROOF PERIMETER DETAIL

NOTE: DWG Files are provided FOR INFORMATION only. DWG Files are generated from ArchiCAD. Non-editable Hardcopies and PDF Files take precedence and in the event of any discrepancies please advise the Architect immediately.

|                                                                                                                    |                            |                                    |
|--------------------------------------------------------------------------------------------------------------------|----------------------------|------------------------------------|
| DRAWING TITLE:<br><b>ROOF DETAILS</b>                                                                              |                            |                                    |
| JOB DESCRIPTION:<br><b>WREKIN COLLEGE BUSINESS SCHOOL</b>                                                          |                            |                                    |
| DRAWING SCALE:<br><b>1:5 @ A1</b>                                                                                  | DATE:<br><b>24-11-2015</b> | DRAWING REF:<br><b>2574-F-200A</b> |
| <b>BAART HARRIES NEWALL</b><br><b>ARCHITECTS</b>                                                                   |                            |                                    |
| 1 WILDERHOPE HOUSE<br>POUNCEY GARDENS<br>BELLE Vue<br>SHREWSBURY SY3 7JU<br>Fax: 01743 349444<br>Tel: 01743 361261 |                            |                                    |